

---

**To:** Kelly Purnell, Puget Sound Energy


**From:** Elson T. "Chip" Barnett, LG, LEG;  
Timothy D. Bailey, PE  
Andrew J. Caneday, LG, LEG

**Date:** September 14, 2018

**File:** 0186-871-07

**Subject:** Energize Eastside Bellevue and Richards Creek Substation:  
City of Bellevue Comment Response

---

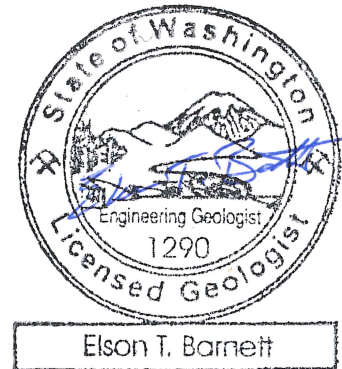

## INTRODUCTION

GeoEngineers, Inc. (GeoEngineers) has prepared this memorandum in response to a City of Bellevue (City) land use review comment related to the Critical Areas Report for the Richards Creeks Substation, dated July 11, 2017. The general location of the Richards Creek Substation is presented in Figure 1, Vicinity Map. Kelly Purnell of Puget Sound Energy (PSE) requested this memorandum during a phone conversation with Chip Barnett on August 16, 2018. This memorandum incorporates comments from Kerry Kriner of PSE received on September 6, 2018. The City provided the following land use review comment in a letter dated August 14, 2018:

“Geotechnical Considerations

Landslide Deposits

The Washington State Department of Natural Resources (DNR) has completed a final draft of a map of landslide deposits in the City of Bellevue. A copy of the May 2018 final draft is attached. The map indicates landslide deposits in the area of the proposed Richards Creek Substation. The geotechnical report and addenda for the Richards Creek Substation do not mention landslide deposits in this area. Please have the geotechnical engineer review the DNR map and provide comments on the map and on potential impacts of landslide deposits on the proposed Richards Creek Substation.”

## COMMENT RESPONSE

We reviewed the draft DNR May 2018 landslide map of Bellevue provided by the City, as well as logs of borings completed in the area mapped as a landslide deposit. We also reviewed aerial imagery and Light Detection and Ranging (LiDAR) hillshade maps of the project area and conducted a reconnaissance of the site in December 2014 and in February 2017. The approximate locations of the borings and the limits of the DNR-mapped landslide in the vicinity of the Richards Creek Substation are presented in Figures 2 and 3.

Borings performed in the vicinity of the Richards Creek Substation suggest that the area is underlain by fill and recessional outwash overlying dense to very dense glacial till. We observed no evidence of landslide deposits in our borings and we observed no indication of landslide activity in the steep slope area on the LiDAR hillshade

(Figure 3) and during our site reconnaissance. Furthermore, it is our opinion that the area mapped as a landslide does not include geomorphic characteristics consistent with a landslide. Based on our review of the LiDAR data (Figure 3), the mapped area does not appear to be a landslide but rather cut and fill slopes associated with site development and roadways, including 139 Avenue SE that is east of the proposed PSE substation.

Based on our review of the available data, it is our opinion that the existing soils underlying the proposed Richards Creek Substation do not appear to be landslide deposits and the mapping performed by DNR is a general characterization of potential conditions within a broader area including the project site and does not represent the actual conditions at the project site.

We appreciate the opportunity to assist you on this project. Please contact us if you have any questions concerning this memorandum or our services.

Attachments:

Figure 1, Vicinity Map

Figure 2, Site Plan Aerial


Figure 3, Site Plan Hillshade

Attachment A, Boring Logs


Attachment B, Previous Explorations

ETB:TDB:AJC:cam

**Disclaimer:** Any electronic form, facsimile or hard copy of the original document (email, text, table, and/or figure), if provided, and any attachments are only a copy of the original document. The original document is stored by GeoEngineers, Inc. and will serve as the official document of record.

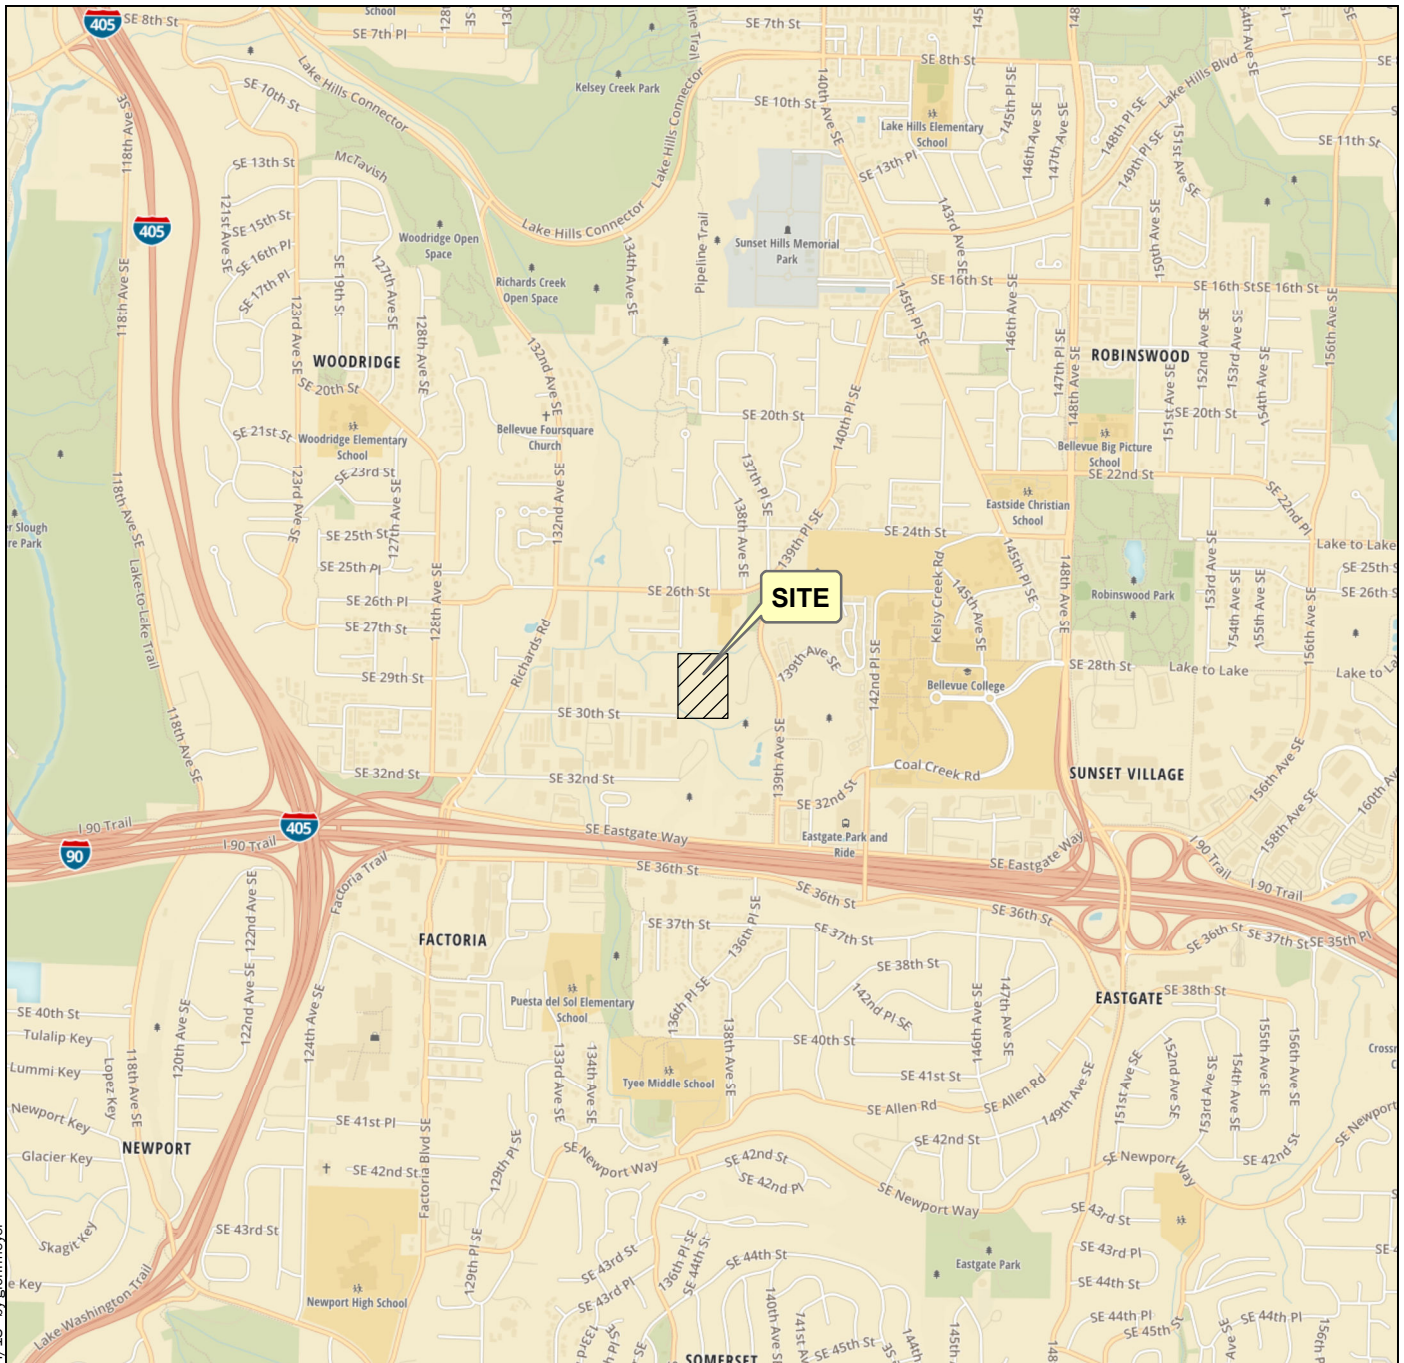

P:\0\048687\1\GIS\WMD\048687\_107\_F01\_VicinityMap.mxd Date Exported: 09/04/18 By: glhofmeyer

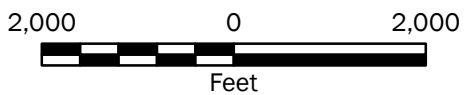

**Vicinity Map**

**PSE Energize Eastside Comment Response  
Bellevue, Washington**



**Figure 1**

- Notes:**
1. The locations of all features shown are approximate.
  2. This drawing is for information purposes. It is intended to assist in showing features discussed in an attached document. GeoEngineers, Inc. cannot guarantee the accuracy and content of electronic files. The master file is stored by GeoEngineers, Inc. and will serve as the official record of this communication.




Data Source: Mapbox Open Street Map, 2016  
 Projection: NAD 1983 StatePlane Washington North FIPS 4601 Feet





P:\010186871\GIS\MXD\018687107\_F02\_SitePlan-Aerial.mxd Date Exported: 09/14/18 by glohnmeyer


Pictometry, King County

**Notes:**  
 1. The locations of all features shown are approximate.  
 2. This drawing is for information purposes. It is intended to assist in showing features discussed in an attached document.  
 GEOENGINEERS, Inc. cannot guarantee the accuracy and content of electronic files. The master file is stored by GeoEngineers, Inc. and will serve as the official record of this communication.  
  
 Data Source: Landslide boundary digitized from City of Bellevue "Landslide Deposits in the City of Bellevue DNR Final Draft - May 2018"  
 Projection: NAD 1983 StatePlane Washington North FIPS 4601 Feet

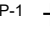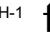- B-1  Boring completed with monitoring well by Geoengineers (2014)
- B-3  Boring completed by GeoEngineers (2014)
- J2, G2-1  Boring completed with monitoring well by Geoengineers (2015) for the Energize Eastside Project
- TP-1  Test pit completed by Converse Consultants (1984)
- HH-1  Hand exploration completed by Converse Consultants (1984)
-  Energize Eastside Right-of-Way
-  City of Bellevue mapped landslide

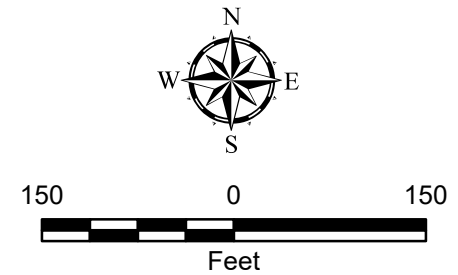

<b>Site Plan - Aerial</b>	
PSE Energize Eastside Comment Response Bellevue, Washington	
	<b>Figure 2</b>

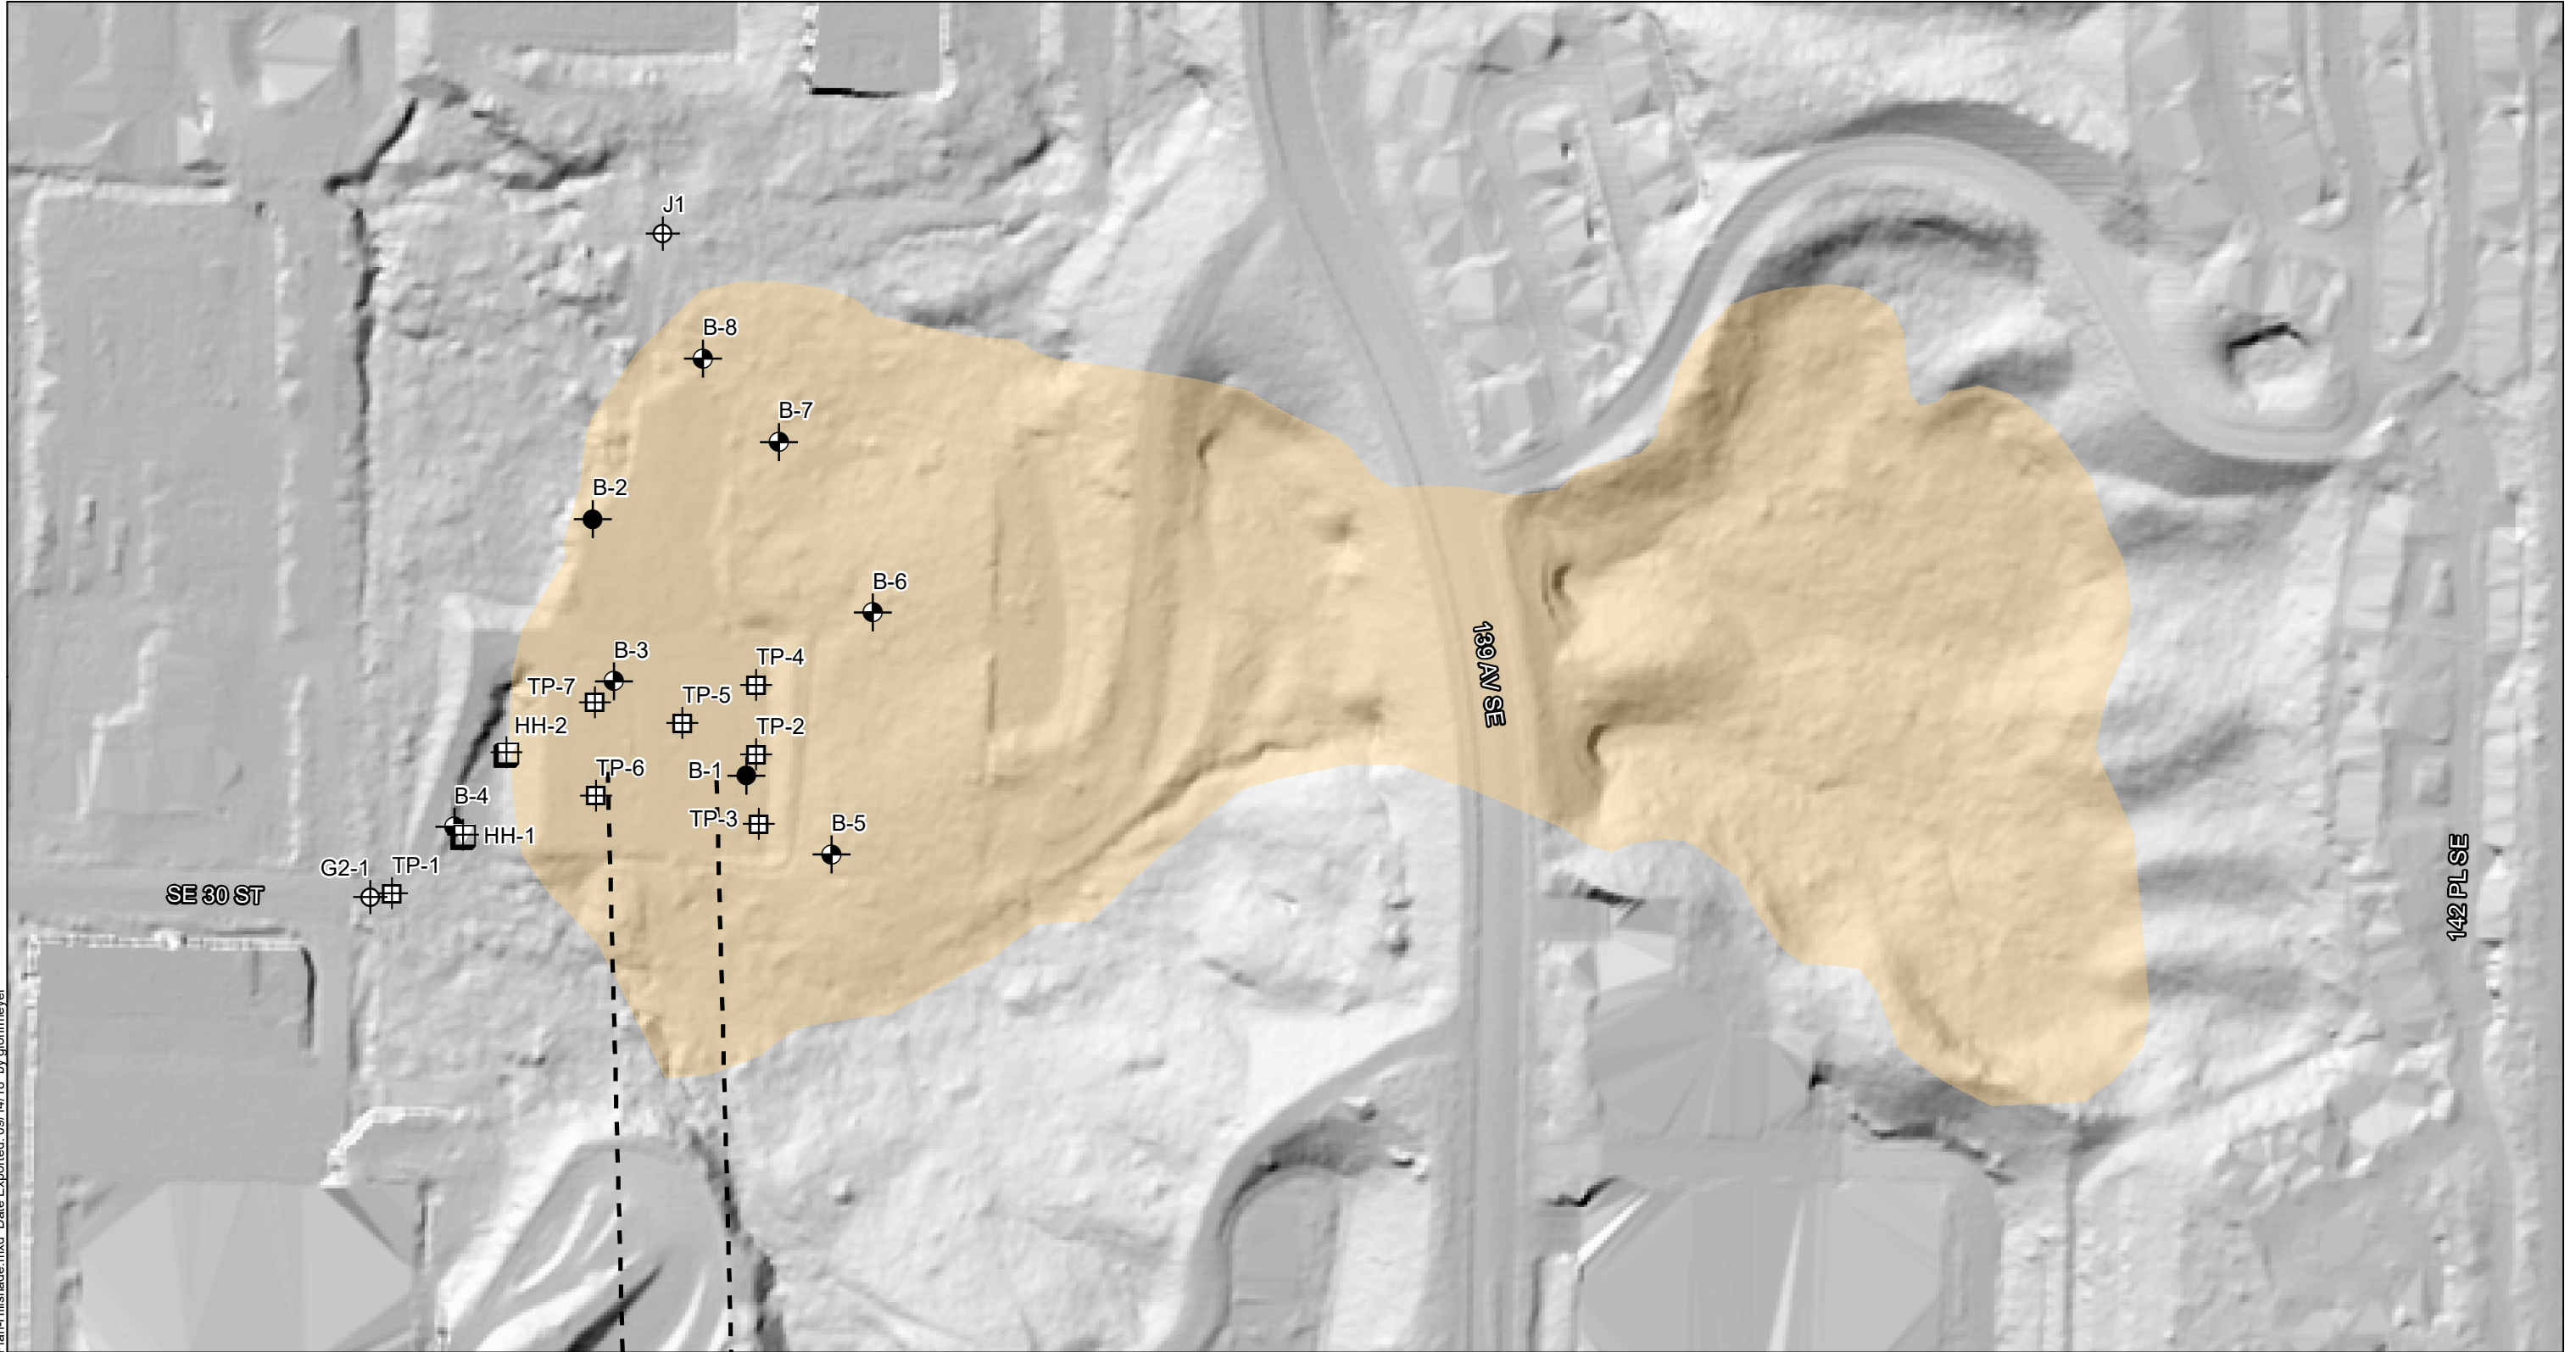


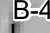

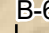

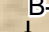
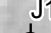
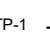

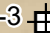











P:\01018687\GIS\MXD\018687107\_F03\_SitePlan-Hillshade.mxd Date Exported: 09/14/18 by glomhmyer

**Notes:**  
 1. The locations of all features shown are approximate.  
 2. This drawing is for information purposes. It is intended to assist in showing features discussed in an attached document. GEOENGINEERS, Inc. cannot guarantee the accuracy and content of electronic files. The master file is stored by GeoEngineers, Inc. and will serve as the official record of this communication.

Data Source: Landslide boundary digitized from City of Bellevue "Landslide Deposits in the City of Bellevue DNR Final Draft - May 2018"

Projection: NAD 1983 StatePlane Washington North FIPS 4601 Feet

- B-1  Boring completed with monitoring well by Geoengineers (2014)
- B-2  Boring completed with monitoring well by Geoengineers (2014)
- B-3  Boring completed by GeoEngineers (2014)
- B-4  Boring completed with monitoring well by Geoengineers (2014)
- B-5  Boring completed with monitoring well by Geoengineers (2014)
- B-6  Boring completed with monitoring well by Geoengineers (2014)
- B-7  Boring completed with monitoring well by Geoengineers (2014)
- B-8  Boring completed with monitoring well by Geoengineers (2014)
- J1, G2-1  Boring completed with monitoring well by Geoengineers (2015) for the Energize Eastside Project
- TP-1  Test pit completed by Converse Consultants (1984)
- TP-2  Test pit completed by Converse Consultants (1984)
- TP-3  Test pit completed by Converse Consultants (1984)
- TP-4  Test pit completed by Converse Consultants (1984)
- TP-5  Test pit completed by Converse Consultants (1984)
- TP-6  Test pit completed by Converse Consultants (1984)
- TP-7  Test pit completed by Converse Consultants (1984)
- HH-1  Hand exploration completed by Converse Consultants (1984)
- HH-2  Hand exploration completed by Converse Consultants (1984)
-  Energize Eastside Right-of-Way
-  City of Bellevue mapped landslide

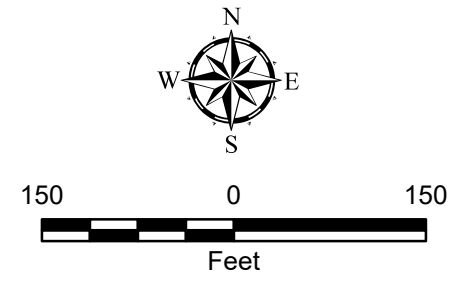

<b>Site Plan - Hillshade</b>	
PSE Energize Eastside Comment Response Bellevue, Washington	
	<b>Figure 3</b>

**ATTACHMENT A**  
**Boring Logs**

## SOIL CLASSIFICATION CHART

MAJOR DIVISIONS			SYMBOLS		TYPICAL DESCRIPTIONS
			GRAPH	LETTER	
COARSE GRAINED SOILS	GRAVEL AND GRAVELLY SOILS	CLEAN GRAVELS <small>(LITTLE OR NO FINES)</small>		<b>GW</b>	WELL-GRADED GRAVELS, GRAVEL - SAND MIXTURES
		GRAVELS WITH FINES <small>(APPRECIABLE AMOUNT OF FINES)</small>		<b>GP</b>	POORLY-GRADED GRAVELS, GRAVEL - SAND MIXTURES
		GRAVELS WITH FINES <small>(APPRECIABLE AMOUNT OF FINES)</small>		<b>GM</b>	SILTY GRAVELS, GRAVEL - SAND - SILT MIXTURES
	SAND AND SANDY SOILS	CLEAN SANDS <small>(LITTLE OR NO FINES)</small>		<b>SW</b>	WELL-GRADED SANDS, GRAVELLY SANDS
		SANDS WITH FINES <small>(APPRECIABLE AMOUNT OF FINES)</small>		<b>SP</b>	POORLY-GRADED SANDS, GRAVELLY SAND
		SANDS WITH FINES <small>(APPRECIABLE AMOUNT OF FINES)</small>		<b>SM</b>	SILTY SANDS, SAND - SILT MIXTURES
FINE GRAINED SOILS	SILTS AND CLAYS	LIQUID LIMIT LESS THAN 50		<b>ML</b>	INORGANIC SILTS, ROCK FLOUR, CLAYEY SILTS WITH SLIGHT PLASTICITY
		LIQUID LIMIT LESS THAN 50		<b>CL</b>	INORGANIC CLAYS OF LOW TO MEDIUM PLASTICITY, GRAVELLY CLAYS, SANDY CLAYS, SILTY CLAYS, LEAN CLAYS
		LIQUID LIMIT LESS THAN 50		<b>OL</b>	ORGANIC SILTS AND ORGANIC SILTY CLAYS OF LOW PLASTICITY
	SILTS AND CLAYS	LIQUID LIMIT GREATER THAN 50		<b>MH</b>	INORGANIC SILTS, MICACEOUS OR DIATOMACEOUS SILTY SOILS
		LIQUID LIMIT GREATER THAN 50		<b>CH</b>	INORGANIC CLAYS OF HIGH PLASTICITY
		LIQUID LIMIT GREATER THAN 50		<b>OH</b>	ORGANIC CLAYS AND SILTS OF MEDIUM TO HIGH PLASTICITY
HIGHLY ORGANIC SOILS				<b>PT</b>	PEAT, HUMUS, SWAMP SOILS WITH HIGH ORGANIC CONTENTS

NOTE: Multiple symbols are used to indicate borderline or dual soil classifications

### Sampler Symbol Descriptions

	2.4-inch I.D. split barrel
	Standard Penetration Test (SPT)
	Shelby tube
	Piston
	Direct-Push
	Bulk or grab
	Continuous Coring

Blowcount is recorded for driven samplers as the number of blows required to advance sampler 12 inches (or distance noted). See exploration log for hammer weight and drop.

A "P" indicates sampler pushed using the weight of the drill rig.

A "WOH" indicates sampler pushed using the weight of the hammer.

NOTE: The reader must refer to the discussion in the report text and the logs of explorations for a proper understanding of subsurface conditions. Descriptions on the logs apply only at the specific exploration locations and at the time the explorations were made; they are not warranted to be representative of subsurface conditions at other locations or times.

## ADDITIONAL MATERIAL SYMBOLS

SYMBOLS		TYPICAL DESCRIPTIONS
GRAPH	LETTER	
	<b>AC</b>	Asphalt Concrete
	<b>CC</b>	Cement Concrete
	<b>CR</b>	Crushed Rock/Quarry Spalls
	<b>TS</b>	Topsoil/Forest Duff/Sod

### Groundwater Contact



Measured groundwater level in exploration, well, or piezometer



Measured free product in well or piezometer

### Graphic Log Contact



Distinct contact between soil strata



Approximate contact between soil strata

### Material Description Contact



Contact between geologic units



Contact between soil of the same geologic unit

### Laboratory / Field Tests

%F	Percent fines
%G	Percent gravel
AL	Atterberg limits
CA	Chemical analysis
CP	Laboratory compaction test
CS	Consolidation test
DS	Direct shear
HA	Hydrometer analysis
MC	Moisture content
MD	Moisture content and dry density
OC	Organic content
PM	Permeability or hydraulic conductivity
PI	Plasticity index
PP	Pocket penetrometer
PPM	Parts per million
SA	Sieve analysis
TX	Triaxial compression
UC	Unconfined compression
VS	Vane shear

### Sheen Classification


NS	No Visible Sheen
SS	Slight Sheen
MS	Moderate Sheen
HS	Heavy Sheen
NT	Not Tested

## KEY TO EXPLORATION LOGS



FIGURE A-1

Start Drilled 12/17/2014	End 12/17/2014	Total Depth (ft) 36.5	Logged By Checked By APL CEW	Driller Geologic Drill	Drilling Method Hollow-stem Auger
Hammer Data Rope & Cathead 140 (lbs) / 30 (in) Drop	Drilling Equipment Deep Rock XL Trailer Rig		DOE Well I.D.: VJ 5K3 A 2 (in) well was installed on 12/17/2014 to a depth of 22 (ft).		
Surface Elevation (ft) Vertical Datum 106.31 NAVD88	Top of Casing Elevation (ft)		Groundwater Date Measured 12/17/2014		
Easting (X) Northing (Y) 1313609.001 215862.8174	Horizontal Datum LiDAR		Depth to Water (ft) 3.8	Elevation (ft) 102.5	
Notes:					

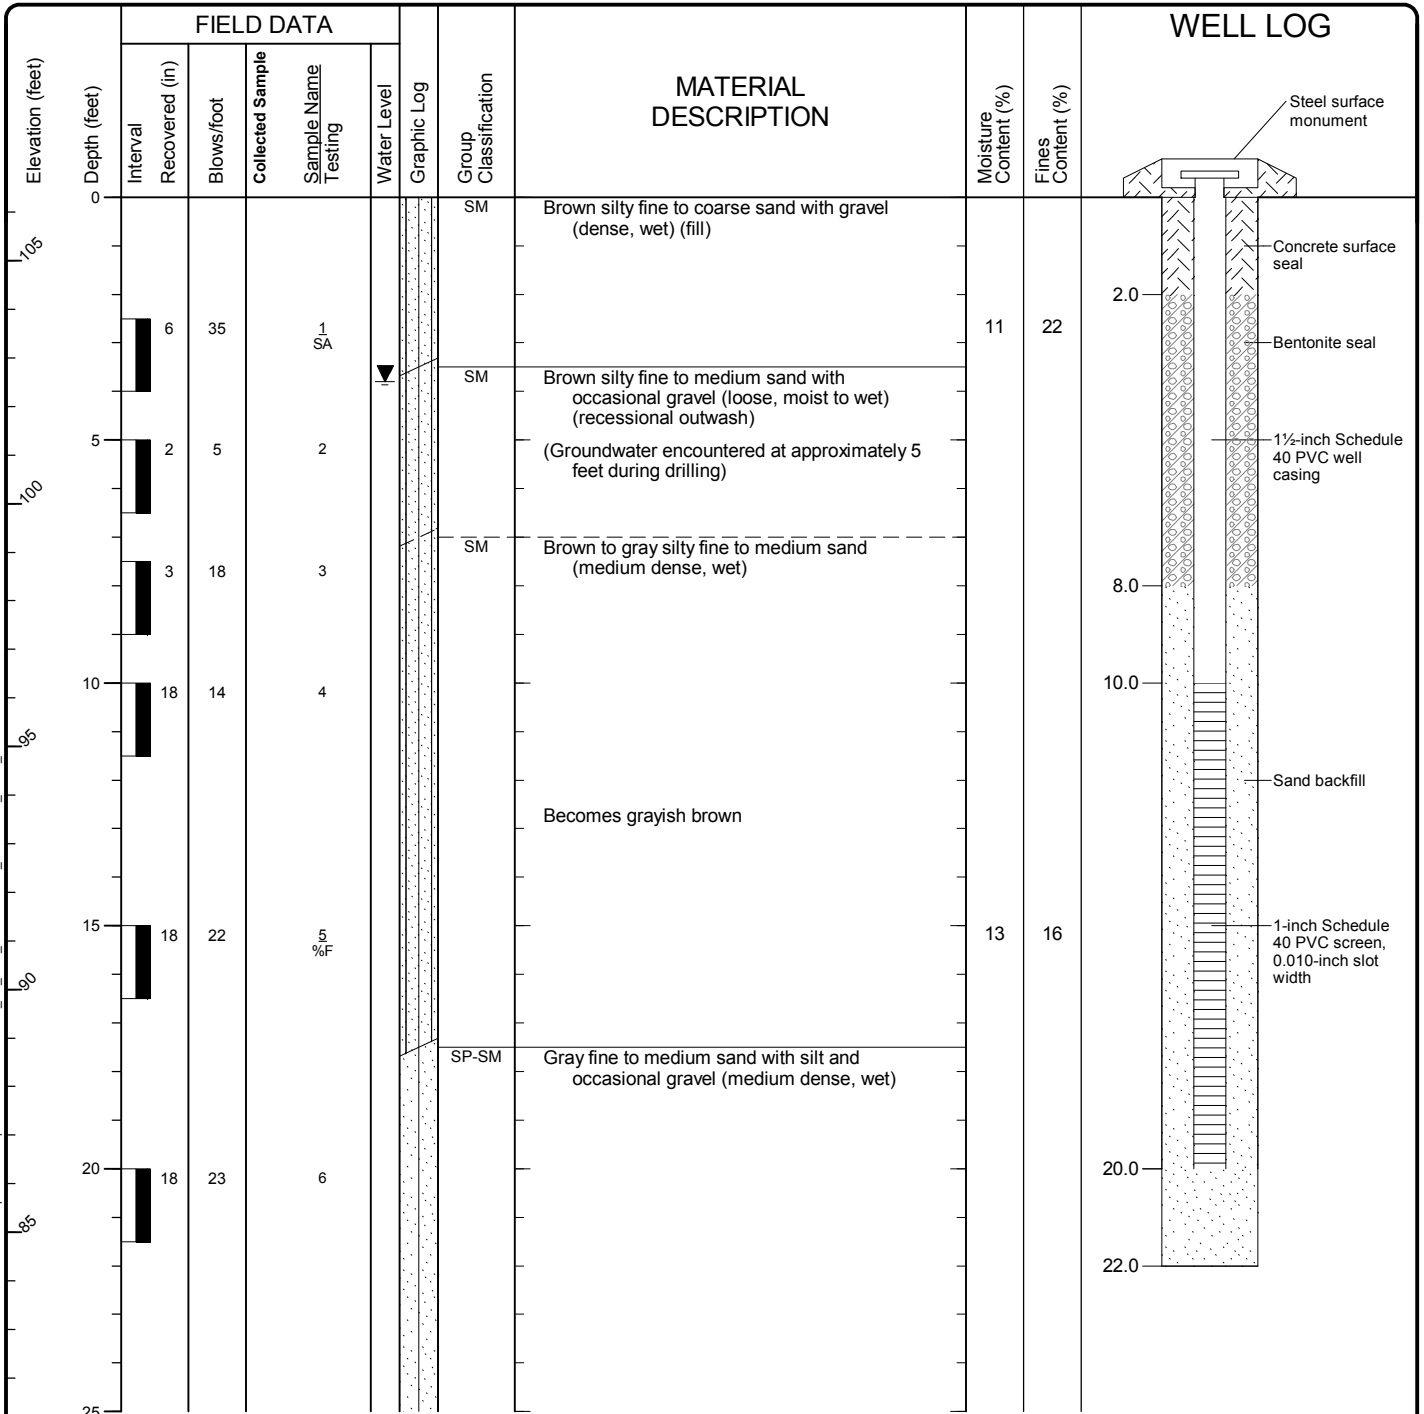

Note: Please see Figure A-1 for explanation of symbols

### Log of Boring B-1



Project: Richards Creek Substation  
 Project Location: Bellevue, Washington  
 Project Number: 0186-922-01

Figure A-2  
 Sheet 1 of 2

Seattle: Date: 9/22/16 Path: W:\PROJECTS\0186922\GINT\018692201\GPJ\_DBT\template\LID\template:GEOENGINEERS\_DF\_STD\_US\_GDT\GEB\_GEOTECH\_WELL\_%F



Seattle: Date: 9/22/16 Path: W:\PROJECTS\0186922\GINT\018692201\GPJ\_DBT\template\LID\template.GEOENGINEERS\_DF\_STD\_US\_GDT\GEB\_GEOTECH\_WELL\_%F

Elevation (feet)	FIELD DATA						MATERIAL DESCRIPTION	Moisture Content (%)	Fines Content (%)	WELL LOG
	Depth (feet)	Interval Recovered (in)	Blows/foot	Collected Sample	Sample Name Testing	Water Level				
25	18	23		7						
30	17	20		8 %F			SM	Gray silty fine to medium sand (medium dense, wet)	20	27
35	7	17		9			SP	Gray fine to medium sand (medium dense, moist to wet)		


Note: Please see Figure A-1 for explanation of symbols

**Log of Boring B-1 (continued)**



Project: Richards Creek Substation  
 Project Location: Bellevue, Washington  
 Project Number: 0186-922-01

Start Drilled 12/17/2014	End 12/17/2014	Total Depth (ft) 36.5	Logged By APL Checked By CEW	Driller Geologic Drill	Drilling Method Hollow-stem Auger
Hammer Data	Rope & Cathead 140 (lbs) / 30 (in) Drop	Drilling Equipment	Deep Rock XL Trailer Rig		
Surface Elevation (ft) Vertical Datum	100.75 NAVD88	Top of Casing Elevation (ft)	DOE Well I.D.: BJ 584 A 2 (in) well was installed on 12/17/2014 to a depth of 22 (ft).		
Easting (X) Northing (Y)	1313467.444 216099.6631	Horizontal Datum	LiDAR		Groundwater Date Measured 12/17/2014
				Depth to Water (ft) 7.4	Elevation (ft) 93.4
Notes:					

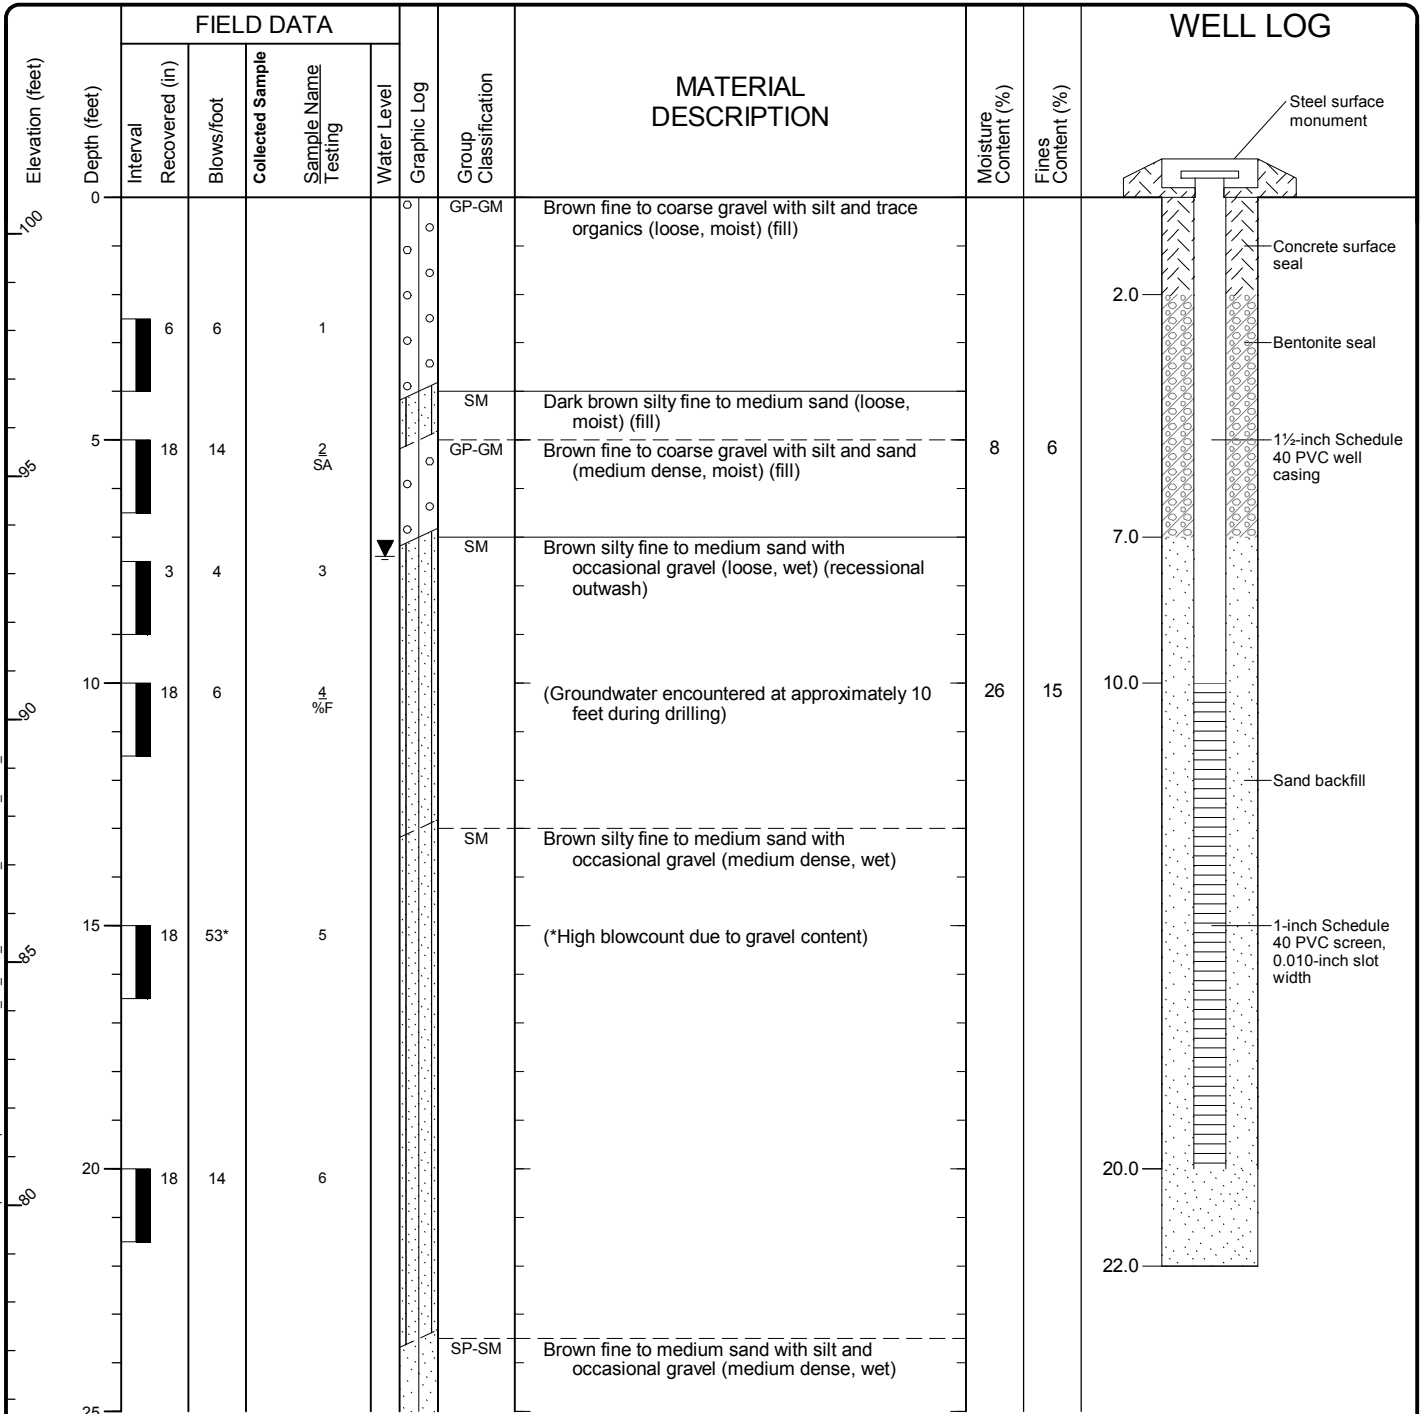

Note: Please see Figure A-1 for explanation of symbols

### Log of Boring B-2



Project: Richards Creek Substation  
 Project Location: Bellevue, Washington  
 Project Number: 0186-922-01

Figure A-3  
 Sheet 1 of 2

Seattle: Date: 9/22/16 Path: W:\PROJECTS\0186922\GINT\0186922\1GPJ\_DBT\template\LID\template:GEOENGINEERS\_DF\_STD\_US\_GDT\GEB\_GEOTECH\_WELL\_%F

Seattle: Date: 9/22/16 Path: W:\PROJECTS\0186922\GINT\018692201\GPJ\_DBT\template\LID\template.GEOENGINEERS\_DF\_STD\_US\_GDT\GEB\_GEOTECH\_WELL\_%F

Elevation (feet)	FIELD DATA						MATERIAL DESCRIPTION	Moisture Content (%)	Fines Content (%)	WELL LOG
	Depth (feet)	Interval Recovered (in)	Blows/foot	Collected Sample	Sample Name Testing	Water Level				
25	18	20		7						
30	18	16		8						
35	18	19		9			CL	Gray clay with sand (very stiff, moist to wet)		

Note: Please see Figure A-1 for explanation of symbols

**Log of Boring B-2 (continued)**



Project: Richards Creek Substation  
 Project Location: Bellevue, Washington  
 Project Number: 0186-922-01

Start Drilled 12/17/2014	End 12/17/2014	Total Depth (ft) 36.5	Logged By Checked By APL CEW	Driller Geologic Drill	Drilling Method Hollow-stem Auger
Surface Elevation (ft) Vertical Datum	102.1 NAVD88	Hammer Data	Rope & Cathead 140 (lbs) / 30 (in) Drop	Drilling Equipment	Deep Rock XL Trailer Rig
Easting (X) Northing (Y)	1313487.143 215949.8592	System Datum	LiDAR	Groundwater Date Measured	Depth to Water (ft) Elevation (ft) See Remarks
Notes:					

Elevation (feet)	FIELD DATA						MATERIAL DESCRIPTION	Moisture Content (%)	Fines Content (%)	REMARKS
	Depth (feet)	Interval Recovered (in)	Blows/foot	Collected Sample	Sample Name Testing	Water Level				
0							CR			1 inch crushed rock surfacing
							SM			Gray silty fine to medium sand with gravel (loose to medium dense, moist) (fill)
100										
	18	16		1				10	35	
5	6	6		2						Groundwater encountered at approximately 5 feet during drilling
65										
	8	4		3				13	21	
10	18	7		4			SM/PT			Gray silty fine to medium sand with peat lenses (loose, wet) (fill/wetland deposits)
90										
15	18	28		5			SP-SM			Brown fine to medium sand with silt and gravel (medium dense, wet) (recessional outwash)
85										
20	18	27		6						
80										
25										

Note: Please see Figure A-1 for explanation of symbols

### Log of Boring B-3



Project: Richards Creek Substation  
 Project Location: Bellevue, Washington  
 Project Number: 0186-922-01

Seattle: Date: 9/22/16 Path: W:\PROJECTS\0186922\GINT\018692201\GPJ\_DBT\template\LOT\template.GEOENGINEERS\_DF\_STD\_US\_GDT\GEB\_GEOTECH\_STANDARD\_%.tif

Seattle: Date: 9/22/16 Path: W:\PROJECTS\0186922\GINT\018692201.GPJ DBT\template\LID\template.GEOENGINEERS\_DF\_STD\_US\_GDT\GEB\_GEOTECH\_STANDARD\_4F

Elevation (feet)	FIELD DATA						MATERIAL DESCRIPTION	Moisture Content (%)	Fines Content (%)	REMARKS
	Depth (feet)	Interval Recovered (in)	Blows/foot	Collected Sample	Sample Name Testing	Water Level				
25	18	17								
30	18	23		8						
35	18	14*		9						*Blowcount may not be representative due to heave

Note: Please see Figure A-1 for explanation of symbols

**Log of Boring B-3 (continued)**



Project: Richards Creek Substation  
 Project Location: Bellevue, Washington  
 Project Number: 0186-922-01

Start Drilled 12/17/2014	End 12/17/2014	Total Depth (ft) 16.5	Logged By Checked By APL CEW	Driller Geologic Drill	Drilling Method Hollow-stem Auger
Surface Elevation (ft) Vertical Datum 87.06 NAVD88	Hammer Data Rope & Cathead 140 (lbs) / 30 (in) Drop	Drilling Equipment Deep Rock XL Trailer Rig			
Easting (X) Northing (Y) 1313340.088 215816.0898	System Datum LiDAR	Groundwater Date Measured	Depth to Water (ft)	Elevation (ft)	
Notes:		See Remarks			

Elevation (feet)	FIELD DATA						MATERIAL DESCRIPTION	Moisture Content (%)	Fines Content (%)	REMARKS
	Depth (feet)	Interval Recovered (in)	Blows/foot	Collected Sample	Sample Name Testing	Water Level				
0							GP-GM			
6.5		18	30		1 SA		GP-GM	8	16	Groundwater encountered at approximately 7.5 feet during drilling
5		12	23		2		SM			
8		0	16		3		GP-GM			
10		18	24		4 %F		GP-GM	13	9	
15		18	32		5		SP-SM			

Note: Please see Figure A-1 for explanation of symbols

### Log of Boring B-4



Project: Richards Creek Substation  
 Project Location: Bellevue, Washington  
 Project Number: 0186-922-01

Figure A-5  
 Sheet 1 of 1

Seattle: Date: 8/22/16 Path: W:\PROJECTS\0186922\GINT\0186922\01.GPJ DBT Template\LOT Template.GE\ENGINEERS\_DF\_STD\_US\_GDT\GEB\_GEOTECH\_STANDARD\_16F

Start Drilled	12/19/2014	End	12/19/2014	Total Depth (ft)	31.5	Logged By	APL	Checked By	CEW	Driller	Geologic Drill	Drilling Method	Hollow-stem Auger
Surface Elevation (ft)	120.93			Hammer Data	Rope & Cathead			Drilling Equipment	Track Mounted Drill Rig				
Vertical Datum	NAVD88						140 (lbs) / 30 (in) Drop						
Easting (X)	1313687.339			System Datum	LiDAR			Groundwater	Date Measured		Depth to Water (ft)	Elevation (ft)	
Northing (Y)	215790.4353											See Remarks	
Notes:													

Elevation (feet)	FIELD DATA						MATERIAL DESCRIPTION	Moisture Content (%)	Fines Content (%)	REMARKS
	Depth (feet)	Interval Recovered (in)	Blows/foot	Collected Sample	Sample Name Testing	Water Level				
120	0						SP			
	5	5	16							
115	5	7	16				SP-SM	3	7	
	10	13	31							
110	10	2	48*				GP-GM			Groundwater encountered at approximately 10 feet during drilling *Blowcount not representative due to gravel content
	15	18	22							
105	15						SP-SM	13	11	
	20	18	25							
100	20									
	25									

Note: Please see Figure A-1 for explanation of symbols

### Log of Boring B-5



Project: Richards Creek Substation  
 Project Location: Bellevue, Washington  
 Project Number: 0186-922-01

Figure A-6  
 Sheet 1 of 2

Seattle: Date: 9/22/16 Path: W:\PROJECTS\0186922\GINT\018692201\GPJ\_DBT\template\LID\template.GEOENGINEERS\_DF\_STD\_US\_GDT\GEB\_GEOTECH\_STANDARD\_%.tif

Seattle: Date: 9/22/16 Path: W:\PROJECTS\0186922\GINT\018692201.GPJ DBT\template\LID\template.GE\ENGINEERS\_DF\_STD\_US\_GDT\GE08\_GEOTECH\_STANDARD\_%F

Elevation (feet)	FIELD DATA						MATERIAL DESCRIPTION	Moisture Content (%)	Fines Content (%)	REMARKS
	Depth (feet)	Interval Recovered (in)	Blows/foot	Collected Sample	Sample Name Testing	Water Level				
25	18	34								
30	18	38		8			SM			Brown silty fine to medium sand (dense, wet) (glacial till)

Note: Please see Figure A-1 for explanation of symbols

**Log of Boring B-5 (continued)**



Project: Richards Creek Substation  
 Project Location: Bellevue, Washington  
 Project Number: 0186-922-01



Start Drilled 12/17/2014	End 12/17/2014	Total Depth (ft) 31.5	Logged By APL Checked By CEW	Driller Geologic Drill	Drilling Method Hollow-stem Auger
Surface Elevation (ft) Vertical Datum 124.23 NAVD88	Hammer Data	Rope & Cathead 140 (lbs) / 30 (in) Drop	Drilling Equipment	Track Mounted Drill Rig	
Easting (X) 1313725.363 Northing (Y) 216013.5373	System Datum	LiDAR	Groundwater Date Measured	Depth to Water (ft)	Elevation (ft)
Notes:			See Remarks		

Elevation (feet)	FIELD DATA						MATERIAL DESCRIPTION	Moisture Content (%)	Fines Content (%)	REMARKS
	Depth (feet)	Interval Recovered (in)	Blows/foot	Collected Sample	Sample Name Testing	Water Level				
0							SM			Groundwater encountered at approximately 5 feet during drilling
120	15	7	1							
5	6	7	2							
115	2	7	3				ML			
10	18	18	4				SP-SM			
110							SM			
15	18	29	5	%F				18 39		
105							SP-SM			
20	18	24	6							
100										
25										

Note: Please see Figure A-1 for explanation of symbols

### Log of Boring B-6



Project: Richards Creek Substation  
 Project Location: Bellevue, Washington  
 Project Number: 0186-922-01

Seattle: Date: 9/22/16 Path: W:\PROJECTS\0186922\GINT\018692201\GPJ\_DBT\template\LOT\template.GE\ENGINEERS\_DF\_STD\_US\_GDT\GEB\_GEOTECH\_STANDARD\_%.F

Seattle: Date: 9/22/16 Path: W:\PROJECTS\0186922\GINT\018692201.GPJ DBT\template\LID\template.GEOENGINEERS\_DF\_STD\_US\_GDT\GEB\_GEOTECH\_STANDARD\_%F

Elevation (feet)	FIELD DATA						MATERIAL DESCRIPTION	Moisture Content (%)	Fines Content (%)	REMARKS
	Depth (feet)	Interval Recovered (in)	Blows/foot	Collected Sample	Sample Name Testing	Water Level				
25	18	23								
30	16	98/10"		8			SM			Gray silty fine to medium sand with gravel (very dense, moist to wet) (glacial till)

Note: Please see Figure A-1 for explanation of symbols

**Log of Boring B-6 (continued)**



Project: Richards Creek Substation  
 Project Location: Bellevue, Washington  
 Project Number: 0186-922-01

Start Drilled	12/19/2014	End	12/19/2014	Total Depth (ft)	21.5	Logged By	APL	Checked By	CEW	Driller	Geologic Drill	Drilling Method	Hollow-stem Auger
Surface Elevation (ft) Vertical Datum	109.8 NAVD88			Hammer Data	Rope & Cathead 140 (lbs) / 30 (in) Drop			Drilling Equipment	Track Mounted Drill Rig				
Easting (X) Northing (Y)	1313639.237 216170.6708			System Datum	LiDAR			Groundwater Date Measured	Depth to Water (ft)	Elevation (ft) See Remarks			
Notes:													

Elevation (feet)	FIELD DATA						Group Classification	MATERIAL DESCRIPTION	Moisture Content (%)	Fines Content (%)	REMARKS
	Depth (feet)	Interval Recovered (in)	Blows/foot	Collected Sample	Sample Name Testing	Water Level					
0							SM	Brown silty fine to medium sand with gravel and trace organics (medium dense, moist to wet) (fill)			Groundwater encountered at approximately 6 feet during drilling
5	8	15		1			SM	Brown silty fine to medium sand with gravel (medium dense, wet) (recessional outwash)			
	13	29		2			SM	Brown to gray silty fine to medium sand (medium dense, wet)			
10	18	16		3			SM	Brown to gray silty fine to medium sand (medium dense, wet)			
	14	12		4 %F			SM	Gray fine to medium sand with silt (medium dense, wet)	24	24	
15	18	16		5			SP-SM	Gray fine to medium sand with silt (medium dense, wet)			
	8	26		6			SM	Gray silty fine sand (medium dense, wet)			
20							SM	Gray silty fine to medium sand (medium dense, wet) (glacial till)			

Note: Please see Figure A-1 for explanation of symbols

### Log of Boring B-7



Project: Richards Creek Substation  
 Project Location: Bellevue, Washington  
 Project Number: 0186-922-01

Seattle: Date: 9/22/16 Path: W:\PROJECTS\0186922\GINT\018692201\GPJ\_DBT\template\LOT\template:GEOENGINEERS\_DF\_STD\_US\_GDT\GEB\_GEOTECH\_STANDARD\_%.tif

Start Drilled 12/19/2014	End 12/19/2014	Total Depth (ft) 16.5	Logged By Checked By APL CEW	Driller Geologic Drill	Drilling Method Hollow-stem Auger
Surface Elevation (ft) Vertical Datum 100.77 NAVD88	Hammer Data	Rope & Cathead 140 (lbs) / 30 (in) Drop	Drilling Equipment	Track Mounted Drill Rig	
Easting (X) Northing (Y) 1313569.145 216247.6339	System Datum	LiDAR		Groundwater Date Measured	Depth to Water (ft) Elevation (ft)
Notes:				See Remarks	

Elevation (feet)	FIELD DATA						MATERIAL DESCRIPTION	Moisture Content (%)	Fines Content (%)	REMARKS
	Depth (feet)	Interval Recovered (in)	Blows/foot	Collected Sample	Sample Name Testing	Water Level				
0							SM			Groundwater encountered at approximately 5 feet during drilling
15	15	5		1			SM			
5	15	17		2			SM			
12	12	30		3			SM			
10	13	24		4			SM			
15	12	23		5 %F				15	16	

Note: Please see Figure A-1 for explanation of symbols

### Log of Boring B-8




Project: Richards Creek Substation  
 Project Location: Bellevue, Washington  
 Project Number: 0186-922-01

Figure A-9  
 Sheet 1 of 1

Seattle: Date: 2/22/16 Path: W:\PROJECTS\0186922\GINT\0186922\1.GPJ DBT Template\LOT Template.GE OENGINEERS\_DF\_STD\_US\_GDT\GEB\_GEOTECH\_STANDARD\_%.MF

**ATTACHMENT B**  
**Previous Explorations**

Start Drilled	8/31/2015	End	8/31/2015	Total Depth (ft)	50.33	Logged By	KMS	Checked By	NT	Driller	Geologic Drill Inc.	Drilling Method	Hollow-stem Auger
Hammer Data	Auto 140 (lbs) / 30 (in) Drop			Drilling Equipment	D50 Track Rig			DOE Well I.D.: BJ 533 A 2 (in) well was installed on 8/31/2015 to a depth of 50 (ft).					
Surface Elevation (ft)	92			Top of Casing Elevation (ft)				<u>Groundwater</u>					
Vertical Datum	NAVD88						<u>Date Measured</u>		<u>Depth to Water (ft)</u>		<u>Elevation (ft)</u>		
Latitude	47.58538°			Horizontal Datum	Geographic WGS84			9/16/2015		0.0		92.0	
Longitude	-122.15791°												
Notes: Field screening was completed to a depth of 15 feet; no sheen was observed.													

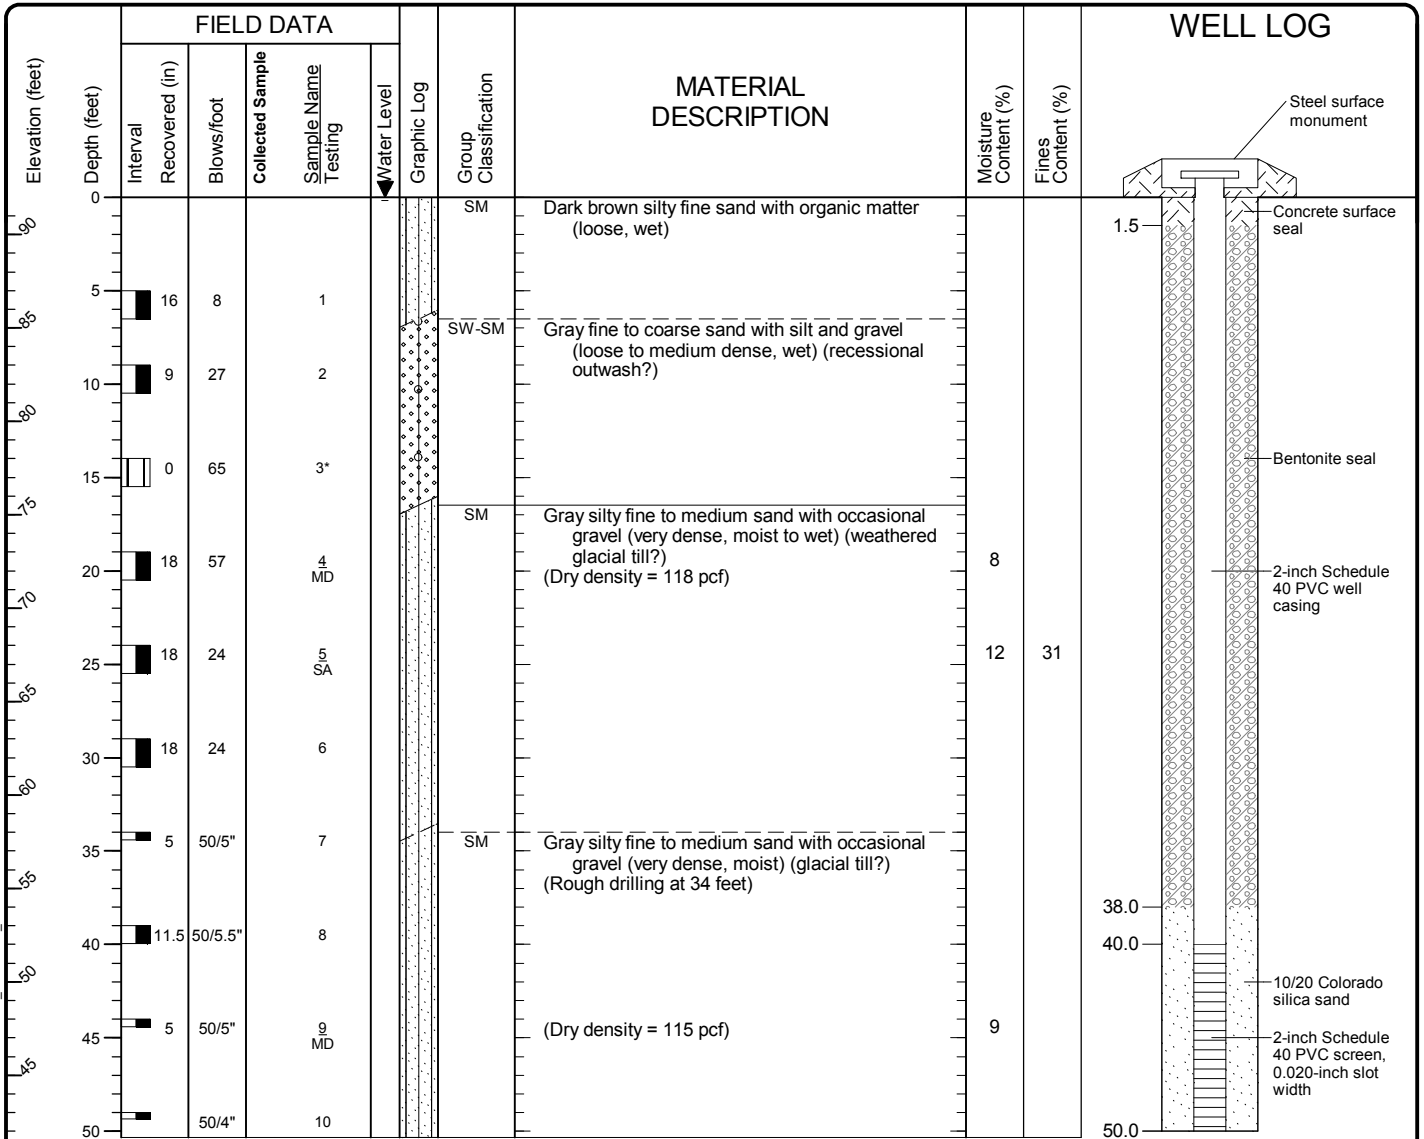

Note: Please see Figure A-1 for explanation of symbols

### Log of Monitoring Well J1 (TL 8/9)




Project: PSE - Energize Eastside Design Phase  
 Project Location: Bellevue, Washington  
 Project Number: 0186-871-05

Figure A-23  
 Sheet 1 of 1

Refmond: Date: 12/21/15 Path: P:\00186871\GINT\0186871\05.GPJ DBTTemplate\lbtTemplate\GEOENGINEERS8.GDT\GEB\_GEOTECH\_WELL

Start Drilled 11/20/2015	End 11/20/2015	Total Depth (ft)	51.5	Logged By Checked By	NLP NT	Driller Geologic Drill Inc.	Drilling Method	Hollow-stem Auger
Hammer Data	Auto 140 (lbs) / 30 (in) Drop			Drilling Equipment		D50 Track Rig		DOE Well I.D.: BIK 311 A 1.5 (in) well was installed on 11/20/2015 to a depth of 35 (ft).
Surface Elevation (ft) Vertical Datum		Undetermined		Top of Casing Elevation (ft)		<u>Groundwater</u> Date Measured 11/20/2015		
Latitude Longitude		Horizontal Datum		Geographic		Depth to Water (ft)		Elevation (ft) 6.0
Notes: Field screening was completed to a depth of 15 feet; no sheen was observed.								

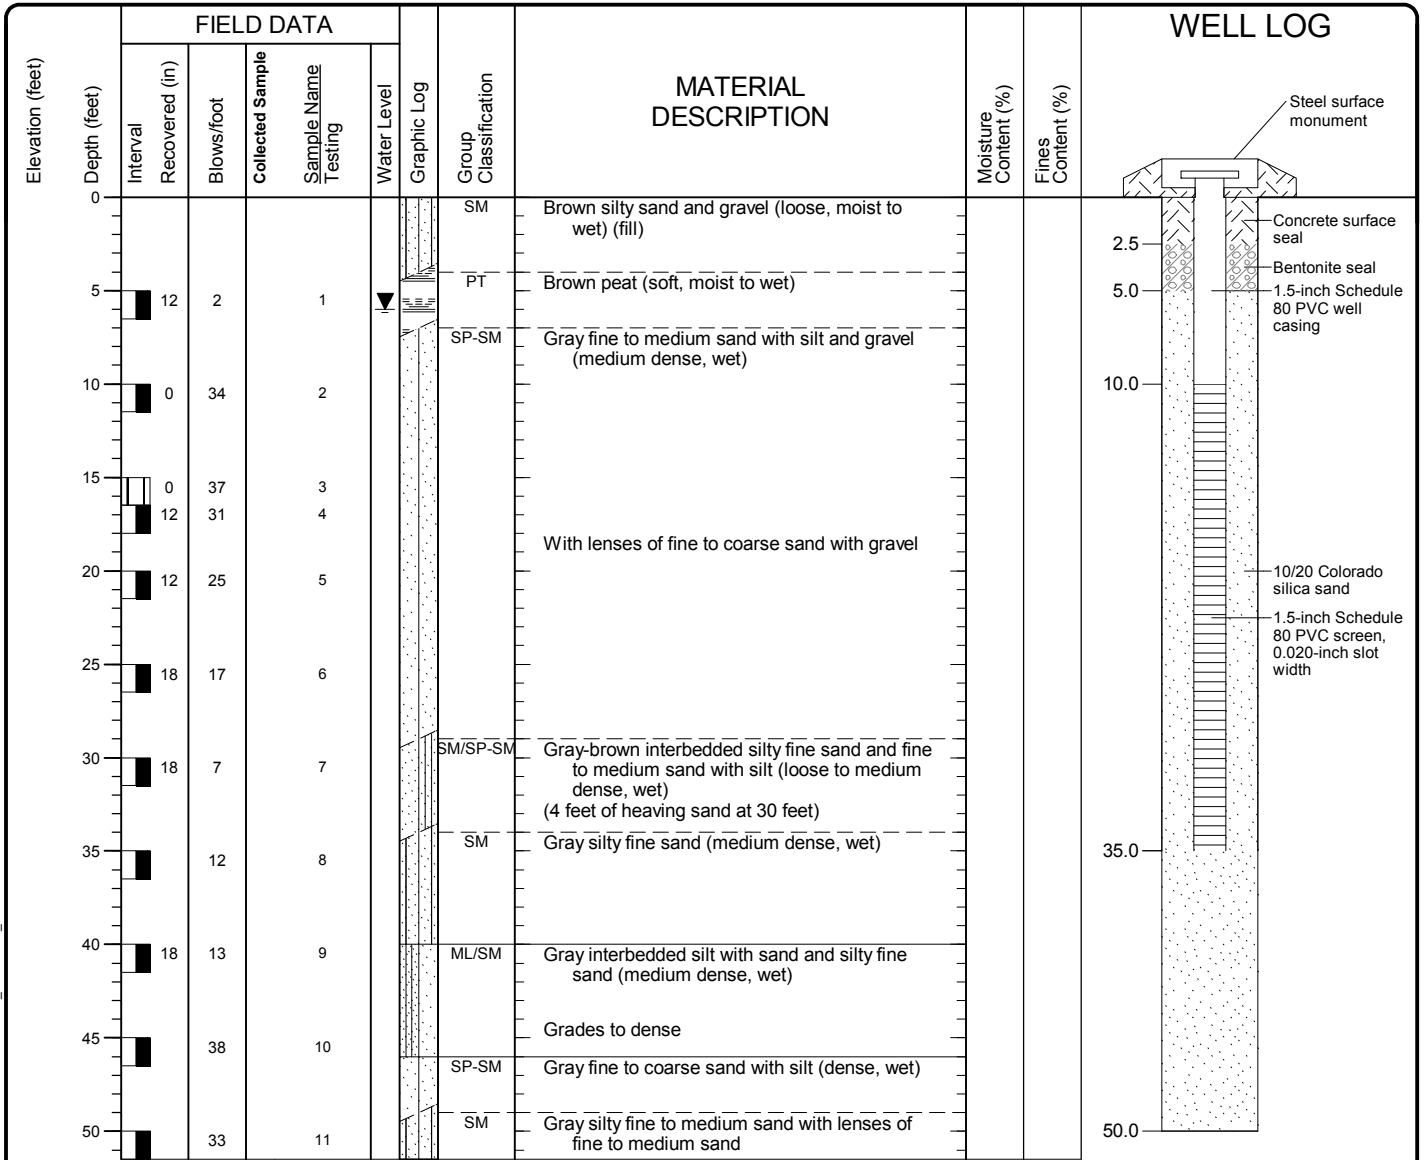

Note: Please see Figure A-1 for explanation of symbols

### Log of Monitoring Well G2-1



Project: PSE - Energize Eastside Design Phase  
 Project Location: Bellevue, Washington  
 Project Number: 0186-871-05

Refmond: Date: 12/15/15 Path: P:\001\86871\GINT\0186871\05.GPJ DBT\template\lbt\template\GEOENGINEERS\GDT\GEB\_GEOTECH\_WELL

## LOG OF TEST PIT NO. 1

Location: See Drawing 1

Elevation: Approx. 77

Surface Conditions: Grass, brush, and blackberries

Depth in feet	Moisture Content-%	Sample	Symbol	DESCRIPTION	REMARKS
1				(0.0 - 1.7) <b>ORGANIC SILT (Fill)</b> ; dark brown, trace fine sand, scattered pieces of wood; wet, soft	moderate caving of test pit walls
2				(1.7 - 3.8) <b>SAND &amp; GRAVEL (Fill)</b> ; gray-brown, fine to coarse, trace silt; wet, medium dense	
3					
4				(3.8 - 5.0) <b>PEAT</b> ; amorphous; wet, soft to medium stiff	
5					
6				(5.0 - 6.2) <b>SILT</b> ; brown, little fine to coarse sand, scattered gravel; wet, loose	
7				(6.2 - 7.6) <b>SILT &amp; SAND</b> ; gray-brown, fine to coarse, trace gravel; wet, medium dense	
8				Bottom of test pit at depth 7.6' Groundwater seepage observed below approx. 2.2' Completed 4/3/84.	

DFR4

PROPOSED POLE YARD  
Bellevue, Washington  
for Puget Sound Power and Light Company

Project No  
84-5107



**Converse Consultants**

Geotechnical Engineering  
and Applied Sciences

Drawing No

2



## LOG OF TEST PIT NO. 2

Location: See Drawing 1

Elevation: Approx. 108

Surface Conditions: Scattered small trees, brush

Depth in feet	Moisture Content-%	Sample	Symbol	DESCRIPTION	REMARKS
1				(0.0 - 0.4) DUFF	
2				(0.4 - 4.4) SAND; gray-brown, fine to medium, trace coarse, trace gravel, trace silt, numerous roots to approx. depth 2'; slightly moist, medium dense	
3		1			
4					
5				(4.4 - 8.3) SAND; gray, fine to coarse, little gravel, trace silt; slightly moist, dense	
6		2			
7				wet below depth 6.6'	
8					
9				(8.3 - 9.5) SILT; mottled gray and brown, trace to little fine sand; wet, dense	
10				(9.5 - 10.4) SAND; brown, fine to medium, trace silt, thin interbeds of brown silt; wet, medium dense	
				Bottom of test pit at depth 10.4'	
				Groundwater seepage observed below approx. 6.6'	
				Completed 4/3/84	

PROPOSED POLE YARD  
Bellevue, Washington  
for Puget Sound Power and Light Company

Project No  
84-5107



**Converse Consultants**

Geotechnical Engineering  
and Applied Sciences

Drawing No

**3**

## LOG OF TEST PIT NO. 3

Location: See Drawing 1

Elevation: Approx. 110

Surface Conditions: Scattered small trees, brush

Depth in feet	Moisture Content-%	Sample	Symbol	DESCRIPTION	REMARKS
1				(0.0 - 0.4) DUFF	
2				(0.4 - 3.6) SAND; brown, fine to medium, trace coarse, trace gravel, trace silt (10%), occasional cobble, numerous roots to approx. 3' depth; slightly moist, medium dense	
3					
4		1		(3.6 - 10.4) SAND; gray, fine to coarse, little gravel, trace silt; slightly moist, dense	
5					
6					
7				very dense	
8					
9					
10					
				Bottom of test pit at depth 10.4'	
				Groundwater seepage observed below approx. 8.6'	
				Completed 4/3/84	

PROPOSED POLE YARD  
Bellevue, Washington  
for Puget Sound Power and Light Company

Project No  
84-5107



**Converse Consultants**

Geotechnical Engineering  
and Applied Sciences

Drawing No.

**4**

## LOG OF TEST PIT NO. 4

Location: See Drawing 1

Elevation: Approx. 107

Surface Conditions: Scattered small trees, brush

Depth in feet	Moisture Content-%	Sample	Symbol	DESCRIPTION	REMARKS
1				(0.0 - 0.4) DUFF	
2				(0.4 - 3.5) SAND; brown, fine to medium, trace coarse, trace silt (10%), trace gravel, numerous roots to approx. depth 2'; slightly moist, loose	
3					
4				(3.5 - 8.1) SAND; gray, fine to coarse, little gravel, trace silt, occasional cobble; slightly moist, medium dense to dense	
5					
6					
7					
8					
9				(8.1 - 11.8) SANDY SILT; mottled gray & brown, fine to medium sand, thin interbeds of fine to medium sand with trace to little silt, thin interbeds of clayey silt with little fine sand; wet, medium dense	
10					
11					
12				Bottom of test pit at depth 11.8' Groundwater seepage observed below approx. 11.4' Completed 4/3/84	

PROPOSED POLE YARD  
Bellevue, Washington  
for Puget Sound Power and Light Company

Project No  
84-5107



**Converse Consultants**

Geotechnical Engineering  
and Applied Sciences

Drawing No

**5**

## LOG OF TEST PIT NO. 5

Location: See Drawing 1

Elevation: Approx. 104

Surface Conditions: Fill surface, scattered grass

Depth in feet	Moisture Content-%	Sample	Symbol	DESCRIPTION	REMARKS
1				(0.0 - 1.2) SILT & SAND (Fill); dark brown, fine to coarse sand, scattered gravel, encountered aluminum debris; moist, loose	
2				(1.2 - 3.4) SILTY SAND (Fill); brown, fine to medium, trace coarse sand, scattered gravel,	
3				scattered pieces of concrete and asphalt rubble up to 1-1/2' across; slightly moist, loose	
4				(3.4 - 5.4) SAND; brown, fine to medium, trace coarse sand, trace gravel, trace to little silt;	
5				slightly moist, medium dense	
6				(5.4 - 10.6) SILTY SAND; gray-brown, fine,	
7				scattered gravel, thin interbeds of silt & fine to medium sand; moist, medium dense	
8				wet below approx. 7.1'	
9					
10					
				Bottom of test pit at depth 10.6'	
				Groundwater seepage observed below approx. 7.1'	
				Completed 4/3/84	

PROPOSED POLE YARD  
Bellevue, Washington  
for Puget Sound Power and Light Company

Project No  
84-5107



**Converse Consultants**

Geotechnical Engineering  
and Applied Sciences

Drawing No

6

## LOG OF TEST PIT NO. 6

Location: See Drawing 1

Elevation: Approx. 107

Surface Conditions: Scattered clumps of grass

Depth in feet	Moisture Content-%	Sample	Symbol	DESCRIPTION	REMARKS
1				(0.0 - 1.7) <b>SAND</b> (Fill); gray, fine to coarse, trace to little gravel, little silt, scattered pieces of concrete & asphalt rubble, wood, and tree branches; moist, loose  (1.7 - 4.6) <b>CLAYEY SILT</b> (Fill); dark gray, fine to medium sand, scattered tree branches, occasional piece of asphalt rubble; moist, very loose wet below approx. 3.1'  (4.6 - 7.3) <b>SAND</b> (Fill); gray, fine to coarse, some clayey silt, numerous tree branches, and pieces of asphalt; wet, very loose  Bottom of test pit at depth 7.3' Test pit terminated due to soil running into pit as excavated below approx. 3' Groundwater seepage observed below approx. 3.1' Completed 4/3/84	
2					
3					
4					
5					
6					
7					

**PROPOSED POLE YARD**  
 Bellevue, Washington  
 for Puget Sound Power and Light Company

Project No  
 84-5107



**Converse Consultants**

Geotechnical Engineering  
and Applied Sciences

Drawing No

**7**

## LOG OF TEST PIT NO. 7

Location: See Drawing 1

Elevation: Approx. 108

Surface Conditions: Grass, fill mounds, scattered concrete rubble

Depth in feet	Moisture Content-%	Sample	Symbol	DESCRIPTION	REMARKS
1				(0.0 - 1.9) SILTY SAND (Fill); gray-brown, fine to medium; slightly moist, loose	
2				(1.9 - 4.1) SILTY SAND (Fill); dark gray-brown, fine to medium, scattered tree branches, pieces of pipe & asphalt rubble; moist, loose	
3				asphalt rubble layer from 2.4' to 3.1'	
4				(4.1 - 6.6) SILTY SAND (Fill); gray, fine to medium, trace coarse, little gravel, occasional cobble; slightly moist, dense	massive caving of test pit walls below approx. 5.5'
5			wet below approx. 4.4'		
6					
7					
8					
9					
				Bottom of test pit at depth 9.6'	
				Groundwater seepage observed below approx. 4.4'	
				Completed 4/3/84	

PROPOSED POLE YARD  
Bellevue, Washington  
for Puget Sound Power and Light Company

Project No  
84-5107



**Converse Consultants**

Geotechnical Engineering  
and Applied Sciences

Drawing No

**8**

HAND DUG HOLE HH-1

<u>Depth (feet)</u>	<u>Description</u>
0.0 - 2.8	PEAT; amorphous; wet
2.8 - 3.1	SAND & GRAVEL; gray-brown, fine to coarse, trace silt; wet
	Bottom of hole at depth 3.1' Water standing in hole at depth 1.2' Completed 4/3/84

HAND DUG HOLE HH-2

<u>Depth (feet)</u>	<u>Description</u>
0.0 - 1.3	PEAT; amorphous; wet
1.3 - 2.0	SAND & GRAVEL; gray-brown, fine to coarse, trace silt; wet
	Bottom of hole at depth 2.0' Completed 4/3/84

LOG OF HAND DUG HOLES

PROPOSED POLE YARD  
Bellevue, Washington  
for Puget Sound Power and Light Company

Project No.  
84-5107

Drawing No.



**Converse Consultants**

Geotechnical Engineering  
and Applied Sciences

**9**